




**NETWORK
DRIVE**
AT NORTHWEST PARK

95 NETWORK DRIVE
Fourth Floor | 50,970 RSF
As-Built



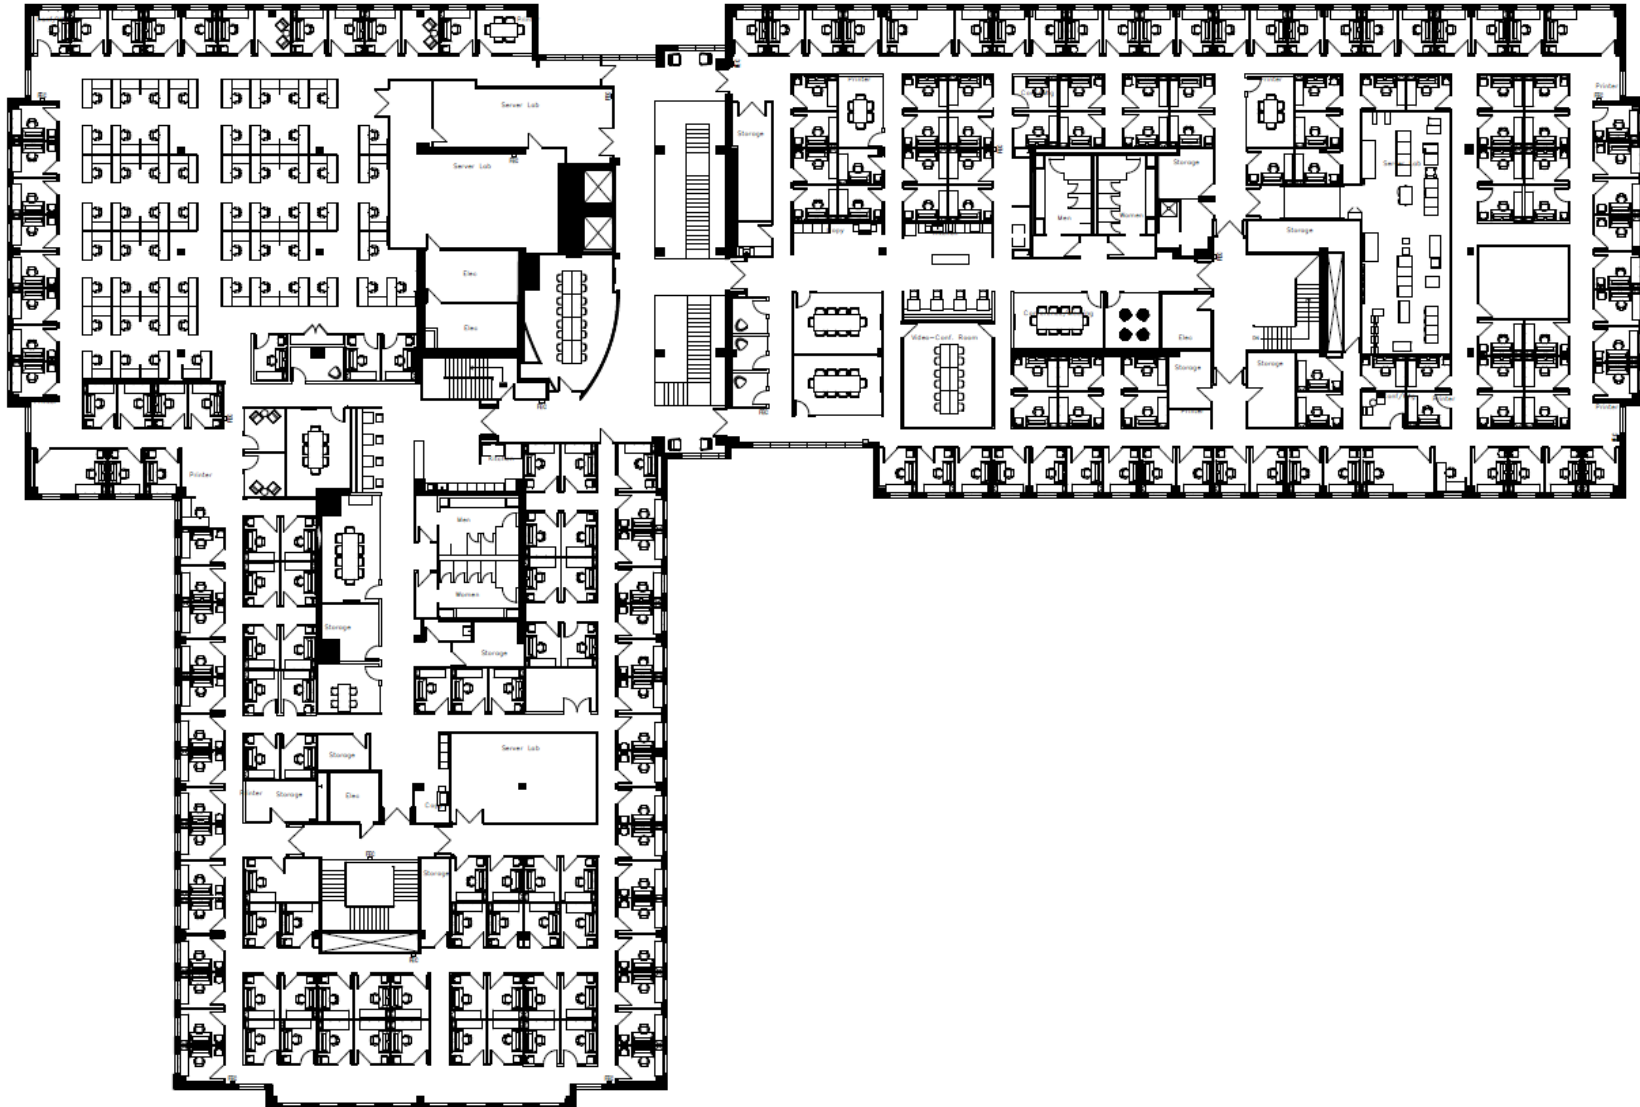

**NETWORK
DRIVE**
AT NORTHWEST PARK

95 NETWORK DRIVE
Fourth Floor | 50,970 RSF

